

February 26, 1981


Douglas County
Engineering Dept.
P.O. Box 426
Minden, NV 89423

SUBJECT: Certificate of Amendment for Glenbrook Subdivision
Unit No. 3-B, Recorded in the Official Records
of Douglas County, Nevada, June 13, 1980, Book
680, Page 1269, Document No. 45299.

Dear Sir:

In accordance with N.R.S. Chapter 278.473, I hereby request that the roadway easement lines as shown on the attached Exhibits "A" and "B" be an integral part of Glenbrook Subdivision Unit 3-B, Sheet 7 of 7.

These roadway easements are necessary in order to encompass the as-built location of the street improvement section and are authorized in the covenants, conditions and restrictions as filed in the official records of Douglas County, Nevada, June 17, 1977, Book 677, Page 1119 through 1177, Document No. 10264; more particularly, paragraph 2, page 1132 of said document.

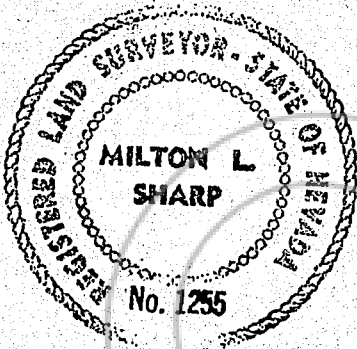

By: *Milton L. Sharp* 2-26-81
Milton L. Sharp
Nevada R.L.S. 1255

I hereby certify that I have examined the certificate of amendment and that the changes to the original document specified therein are provided for in applicable sections of NRS 278.010 to 278.630, inclusive, NRS 625.340 to 625.380, inclusive, and local ordinances adopted pursuant thereto, and I am satisfied that this certificate of amendment so amends the document as to make it technically correct.

RECEIVED


FEB 27 1981

DOUGLAS CO. PLANNING DEPT.

By: *Walter C. Phillips*
Douglas County

3/3/81

53983
LIBER 381 PAGE 117

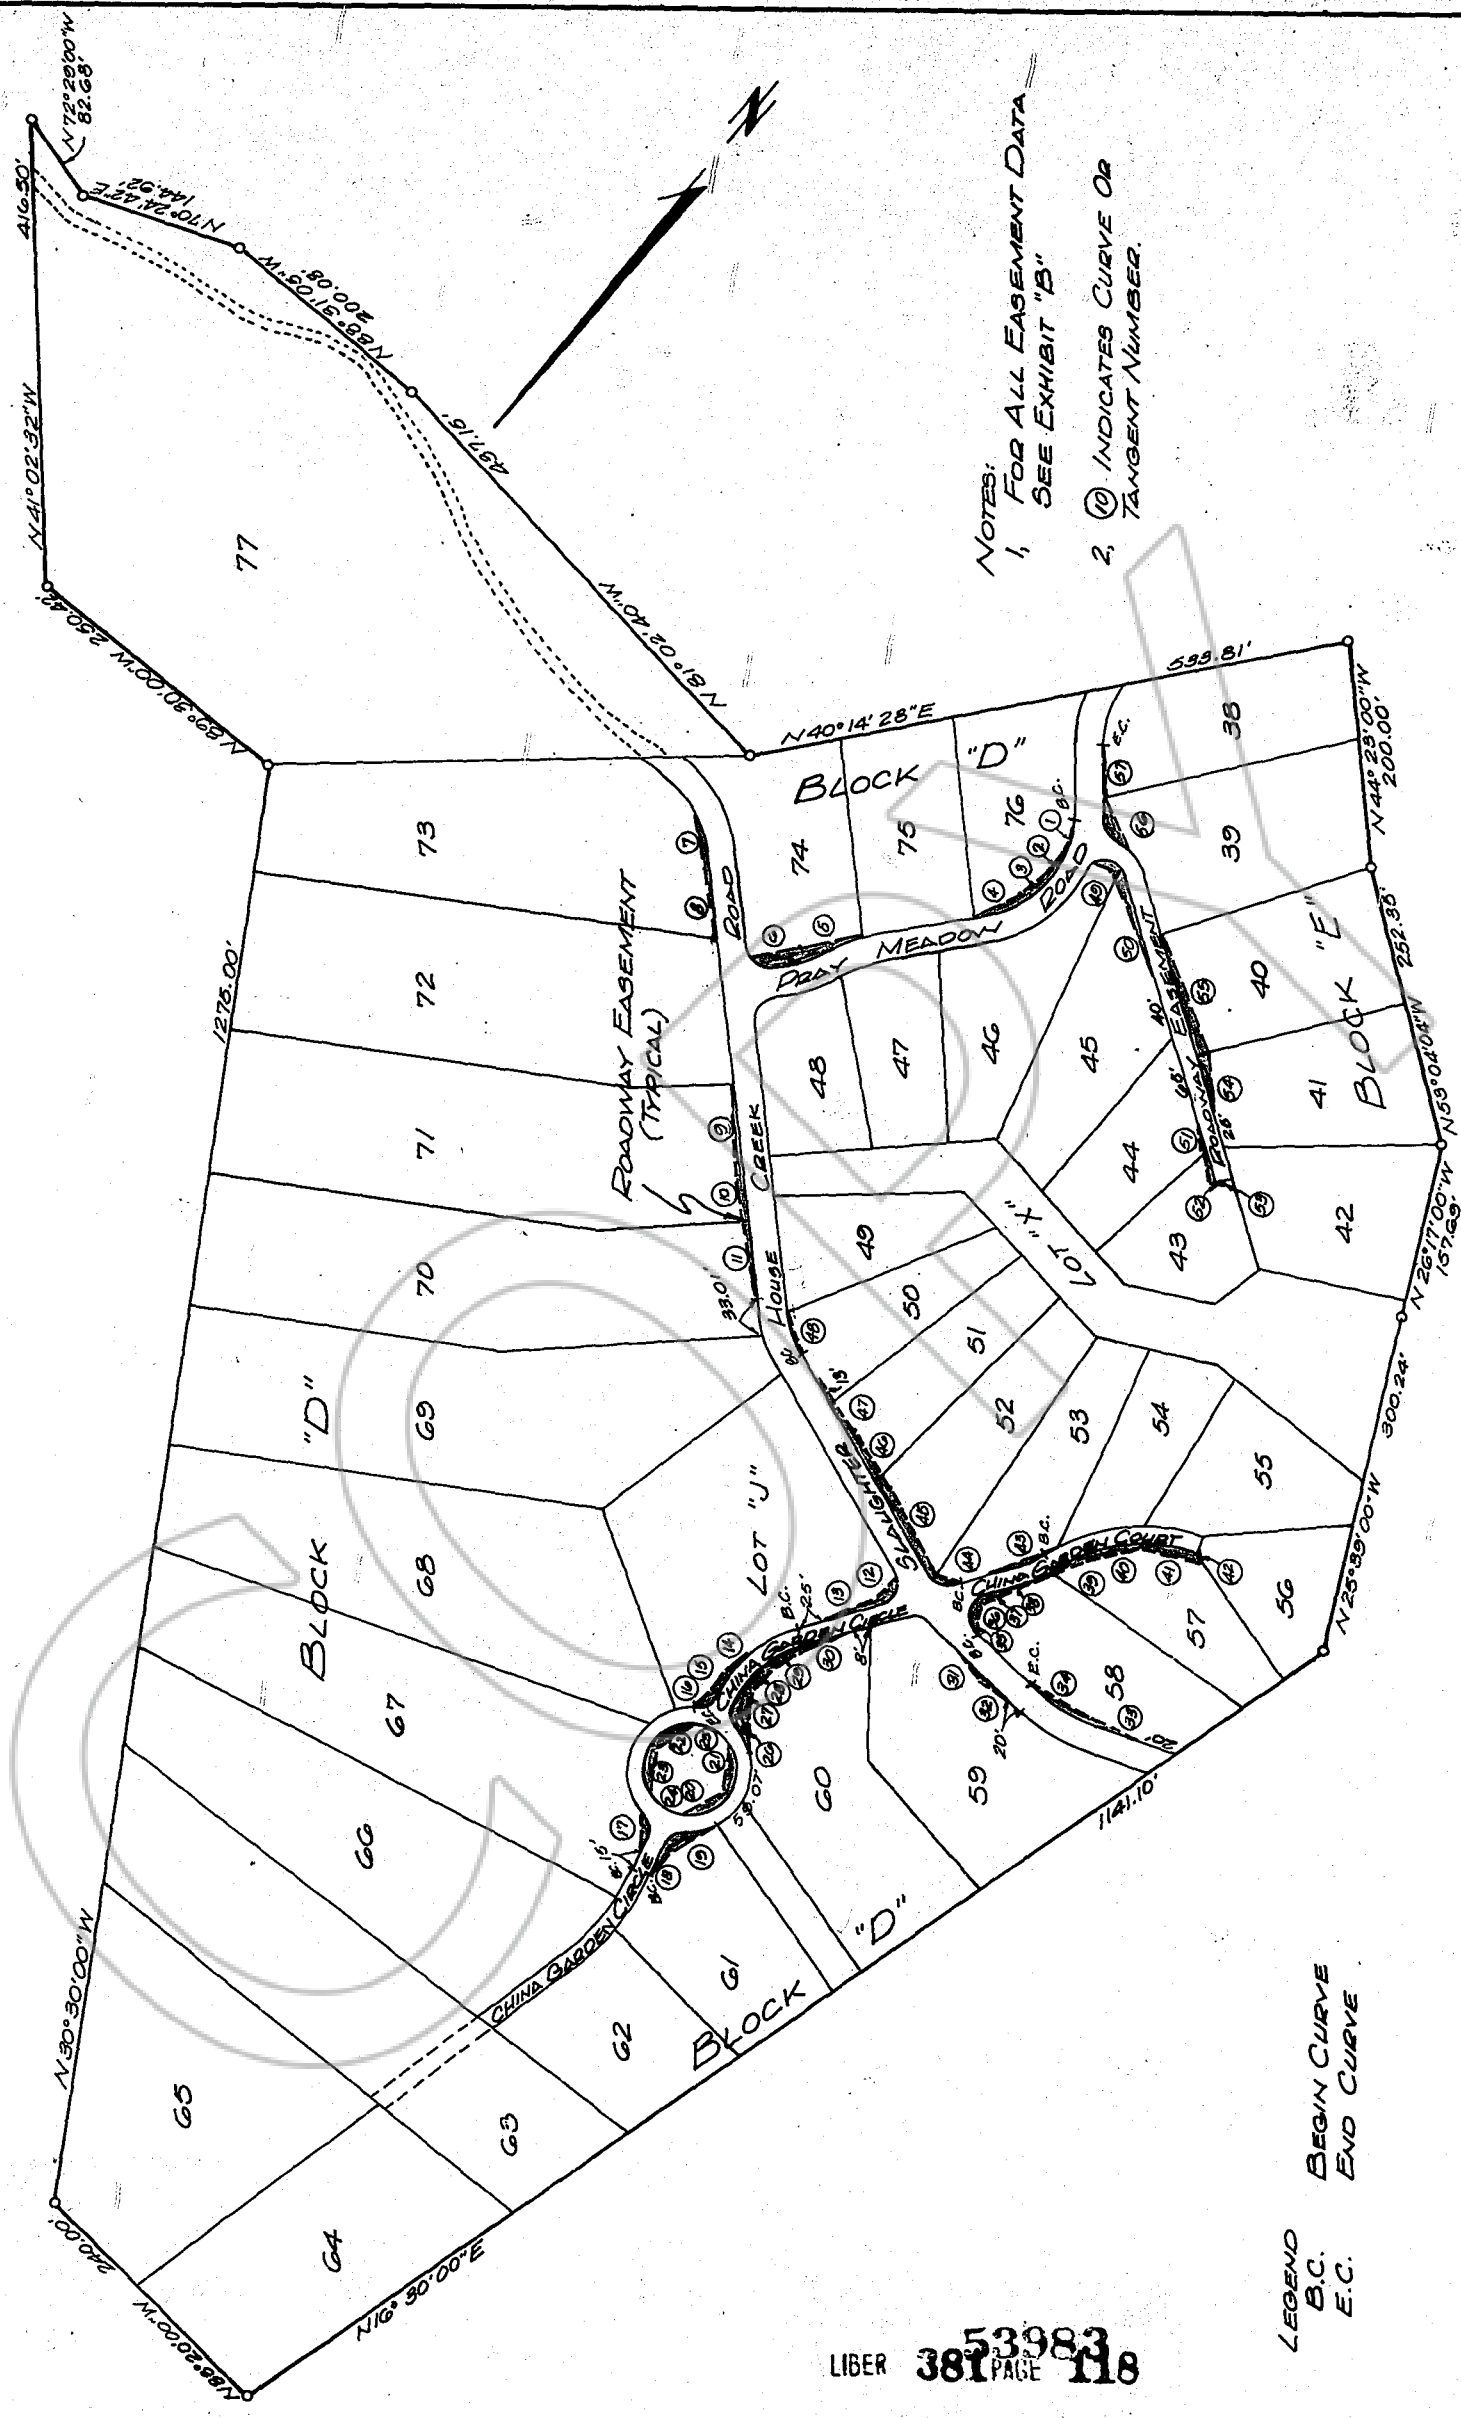

NOTES:
 1. FOR ALL EASEMENT DATA SEE EXHIBIT "B"
 2. (10) INDICATES CURVE OR TANGENT NUMBER.

LEGEND
 B.C. BEGIN CURVE
 E.C. END CURVE

LIBER 381 PAGE 118
 53983

EXHIBIT "A"
 GLENBROOK UNIT 3-B
 ROAD EASEMENT

SHARP, KRATER & ASSOCIATES
 ENGINEERS/PLANNERS/SURVEYORS
 P.O. Box 11456
 Reno, Nevada 89510
 Ph. 702-329-6401

REDUCED PLAN - NOT TO SCALE

No.	BEARING	DISTANCE
41	N 56° 55' 07" E	66.83'
42	N 39° 07' 47" W	11.69'
43	N 33° 52' 01" E	79.35'
44	S 82° 24' 19" W	22.23'
45	N 72° 00' 46" W	76.10'
46	N 62° 20' 01" W	51.68'
47	N 74° 57' 03" W	57.86'
48	N 57° 00' 03" W	36.59'
49	N 62° 37' 43" E	14.58'
50	N 60° 34' 14" W	120.63'
51	N 53° 01' 59" E	87.91'
52	N 36° 58' 01" W	20.00'
53	S 56° 32' 31" W	5.19'
54	N 47° 10' 37" W	58.74'
55	N 59° 04' 49" W	112.37'
56	N 58° 10' 28" W	43.00'
57	N 42° 23' 41" W	46.06'

No.	BEARING	DISTANCE
1	N 40° 51' 14" W	36.13'
2	N 18° 54' 27" W	20.62'
3	N 08° 27' 58" W	38.28'
4	N 19° 13' 14" E	44.38'
5	N 38° 51' 31" E	56.14'
6	N 37° 06' 29" E	40.27'
7	N 49° 06' 17" W	35.00'
8	N 49° 06' 17" W	69.84'
9	N 40° 30' 52" W	76.62'
10	N 45° 00' 38" W	46.69'
11	N 51° 47' 29" W	50.67'
12	N 10° 50' 55" E	21.75'
13	N 26° 40' 01" E	52.55'
14	N 10° 28' 20" E	23.24'
15	N 09° 15' 11" E	21.87'
16	N 07° 43' 08" W	24.07'
17	N 36° 23' 59" W	35.44'
18	N 06° 02' 24" E	45.68'
19	N 18° 42' 55" E	38.12'
20	N 08° 14' 47" E	35.47'
21	N 35° 18' 42" W	35.55'
22	N 10° 46' 04" E	40.58'
23	N 41° 30' 27" W	43.04'
24	N 56° 14' 42" W	26.16'
25	N 41° 30' 33" W	27.95'
26	N 08° 29' 39" E	22.36'
27	N 15° 26' 20" E	27.49'
28	N 29° 57' 36" E	74.24'
29	S 77° 53' 24" E	28.69'
30	N 87° 07' 20" E	19.24'
31	N 76° 35' 17" E	61.73'
32	N 80° 08' 44" E	62.01'
33	N 57° 30' 08" W	10.66'
34	N 13° 46' 44" W	16.04'
35	N 13° 35' 26" E	8.08'
36	S 28° 55' 55" W	38.74'
37	N 31° 05' 16" E	48.09'
38	N 36° 17' 16" E	39.86'

CURVE DATA

No.	DELTA	RADIUS	LENGTH
24	45° 08' 10"	39.00'	30.67'
25	50° 37' 58"	39.00'	34.46'

REQUESTED BY
Donalson Property
 IN OFFICIAL RECORDS OF
 DOUGLAS CO. NEVADA
No Fee
 1981 MAR -3 AM 11:00
 MARIE A. RABEL
 RECORDER
Carol Chapman
Rep.

EXHIBIT "B"

GLENBROOK UNIT 3-B
 ROAD EASEMENT DATA

SHARP, KRATER & ASSOCIATES
 ENGINEERS / PLANNERS / SURVEYORS
 P.O. Box 11456
 Reno, Nevada 89510 Ph. 702-329-6401